

NOTES

LEGEND

 UNIT NUMBER


CHANNEL NUMBER

THIS DRAWING REPRESENTS VISUAL CONCEPTS AND CONSTRUCTION SUGGESTIONS ONLY. IT DOES NOT REPLACE THE KNOWLEDGE AND ADVICE OF A LICENSED STRUCTURAL ENGINEER. THE DESIGNER IS UNQUALIFIED TO DETERMINE THE STRUCTURAL APPROPRIATENESS OF THIS DESIGN AND WILL NOT ASSUME RESPONSIBILITY FOR IMPROPER ENGINEERING OR USE.

The University of Maryland- TDPS
Noises Off "As-Built" Plot
The Clarice Smith Performing Arts Center
Kay Theatre



DATE 5.1.20	VERSION 3	SCALE 3/8" = 1'	Sheet Number 1 OF 4
Overheads			

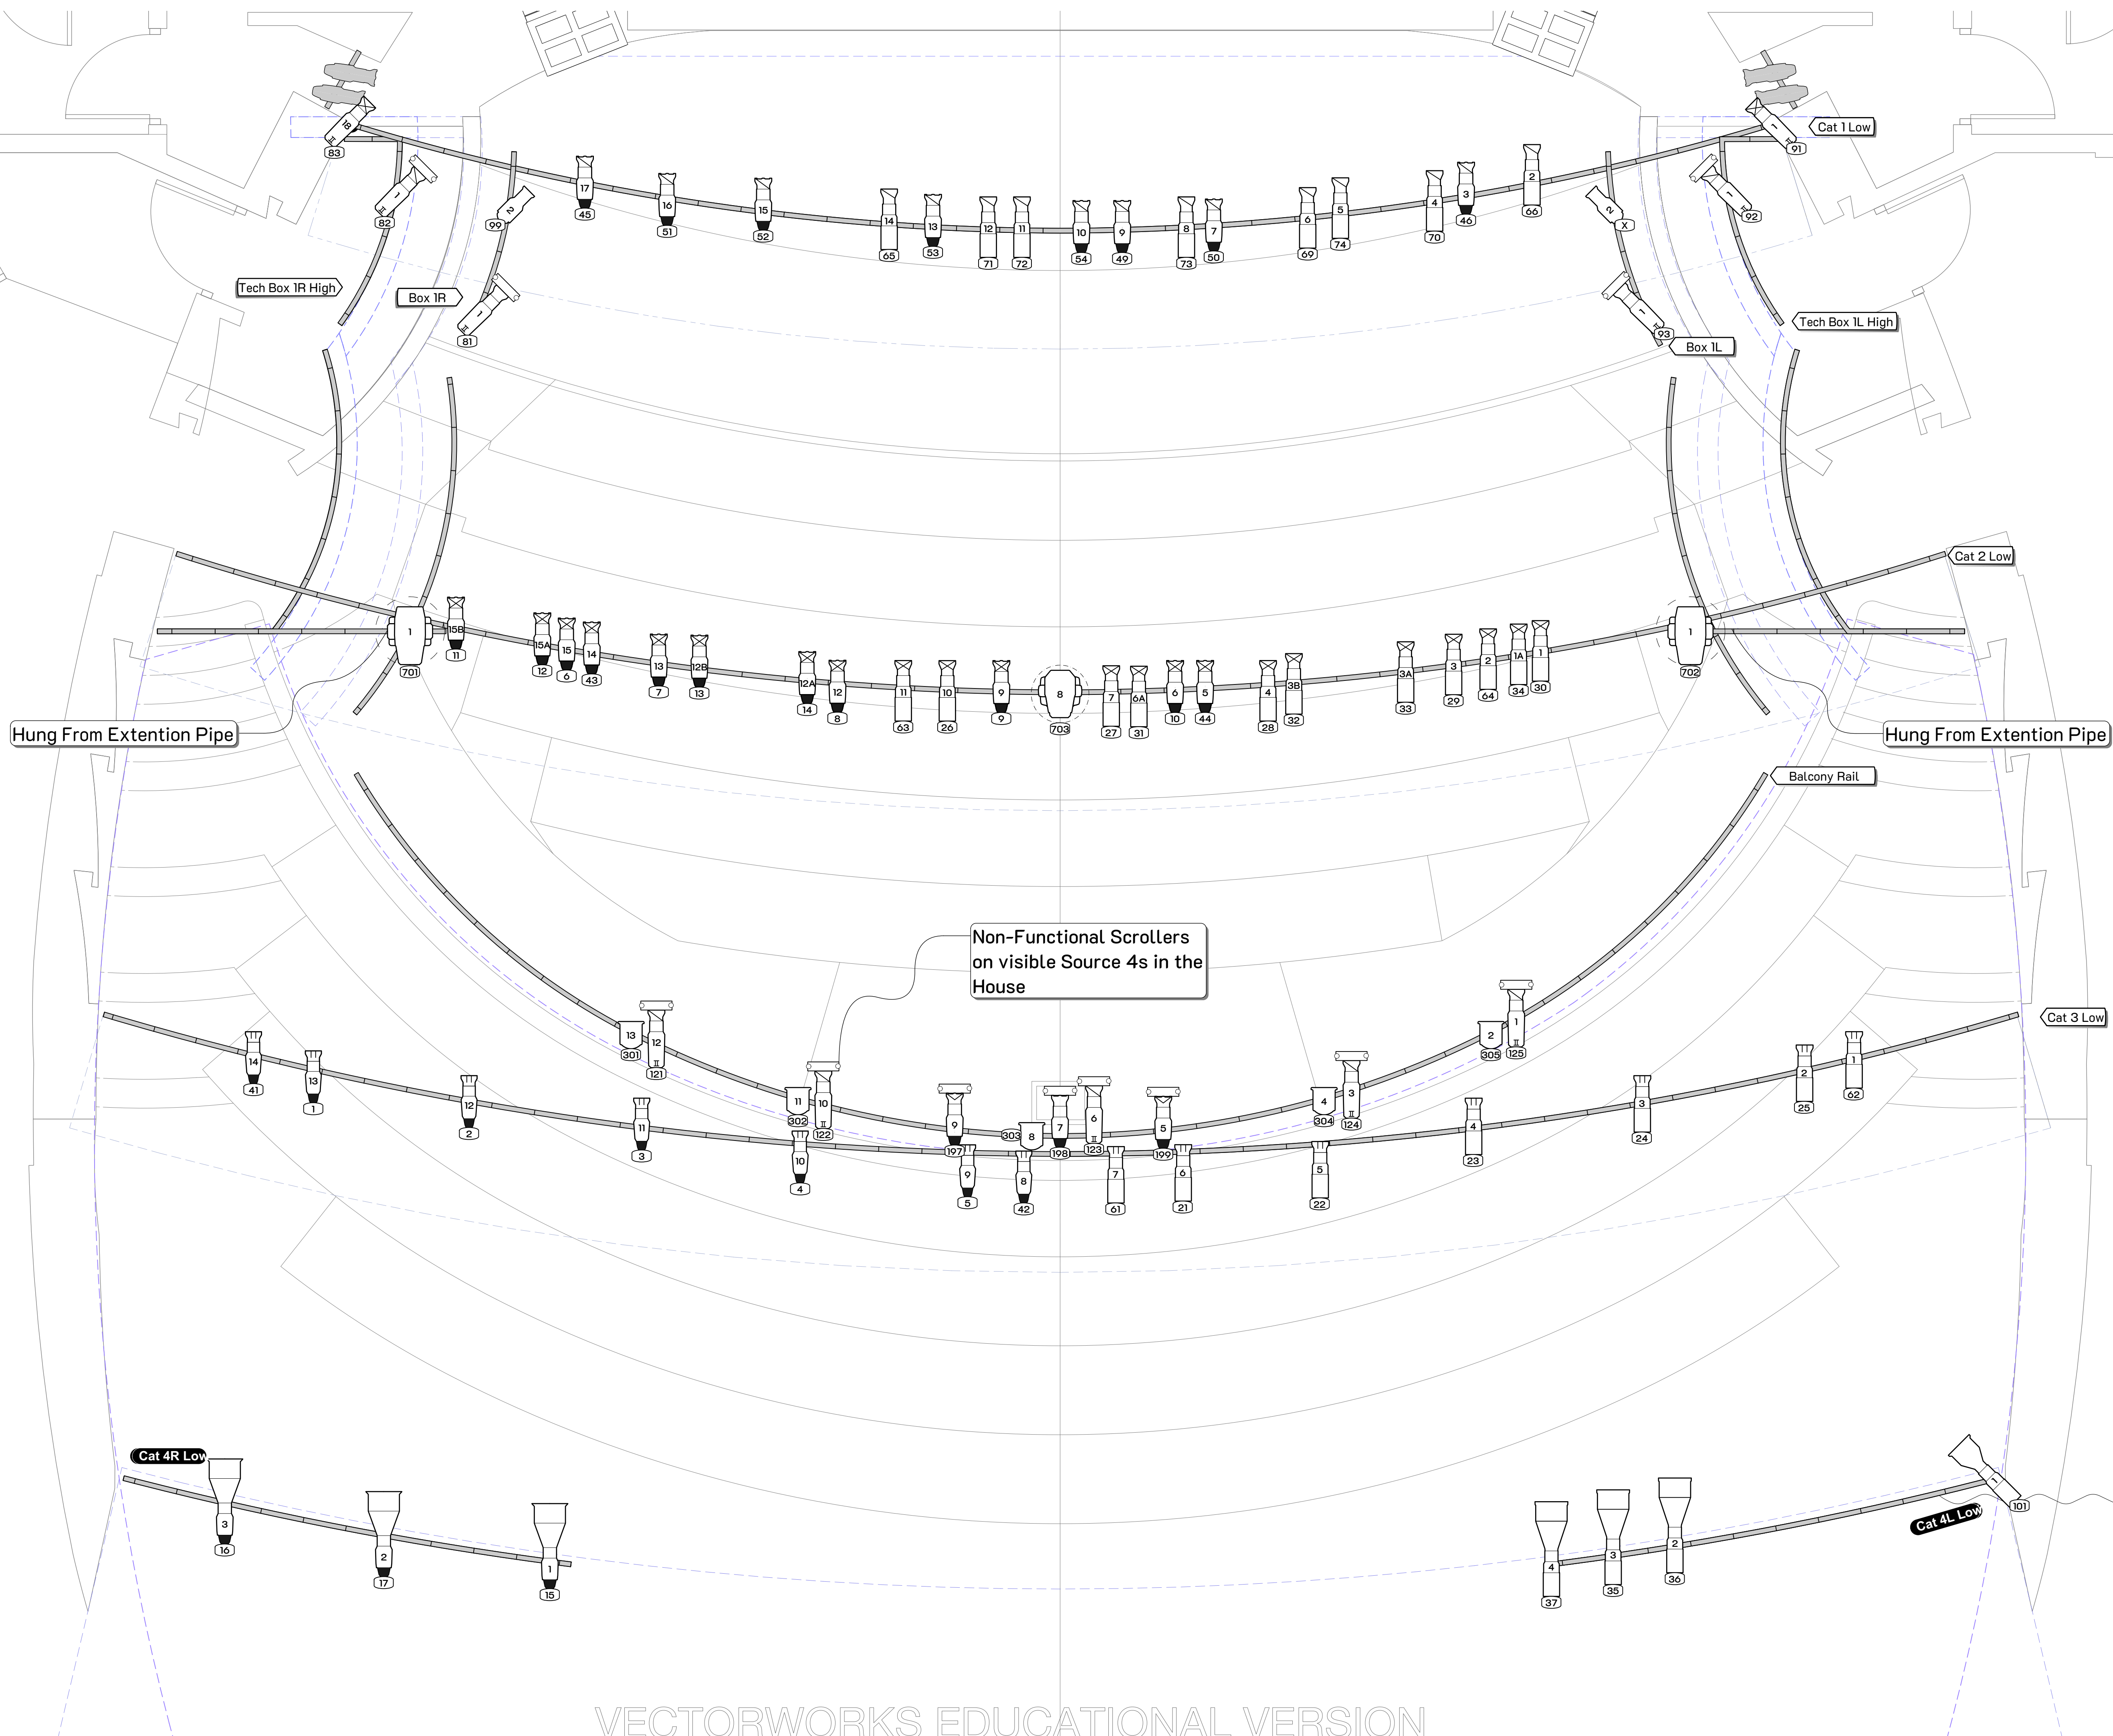

KEY

Source 4 Bodies

- Source 4 575w
- Source 4 750w
- Source 4 Lustre
- ColorSource Spot

Source 4 Barrels

- 5"
- 10"
- 14"
- 10"
- 20"
- 36"
- 50"
- 70"
- 90"

Sola Frame 1000

SolaFrame 3000

Varilite VLX Wash

Robe Robin 150

PL Cyc

8" Fresnel

Fauxnel

Practical

60w Blue Bulb

Colorblaze TRX

14in Scoop

Altman 360Q 6x9

10" Barndoor

6.25in Half Top hat

M Fader Scroller

NOTES

LEGEND

1 UNIT NUMBER

2 CHANNEL NUMBER

VERSION	DATE	NOTE

THIS DRAWING REPRESENTS VISUAL CONCEPTS AND CONSTRUCTION SUGGESTIONS ONLY. IT DOES NOT REPLACE THE KNOWLEDGE AND ADVICE OF A LICENSED STRUCTURAL ENGINEER. THE DESIGNER IS UNQUALIFIED TO DETERMINE THE STRUCTURAL APPROPRIATENESS OF THIS DESIGN AND WILL NOT ASSUME RESPONSIBILITY FOR IMPROPER ENGINEERING OR USE.

Director	Lisa Nathans
Lighting Designer	J. Mitchell Cronin
Scenic Designer	Ryan Fox
Costume Designer	Ashlynn Ludwig
Sound Designer	Bill Brandwein
Asst. Lighting Designer	Matory Hartman
Master Electrician	Carrie Barton

The University of Maryland- TDPS

Noises Off "As-Built" Plot

The Clarice Smith Performing Arts Center

Key Theatre

Noises Off

J. MITCHELL CRONIN

LIGHTING DESIGN

JMC



(201) 840-0488

JMC_Design@jmc.com

www.JMCDesigns.info

DATE	VERSION	SCALE	Sheet Number
5.1.20	3	3/8" = 1'	2 OF 4

FRONT OF HOUSE

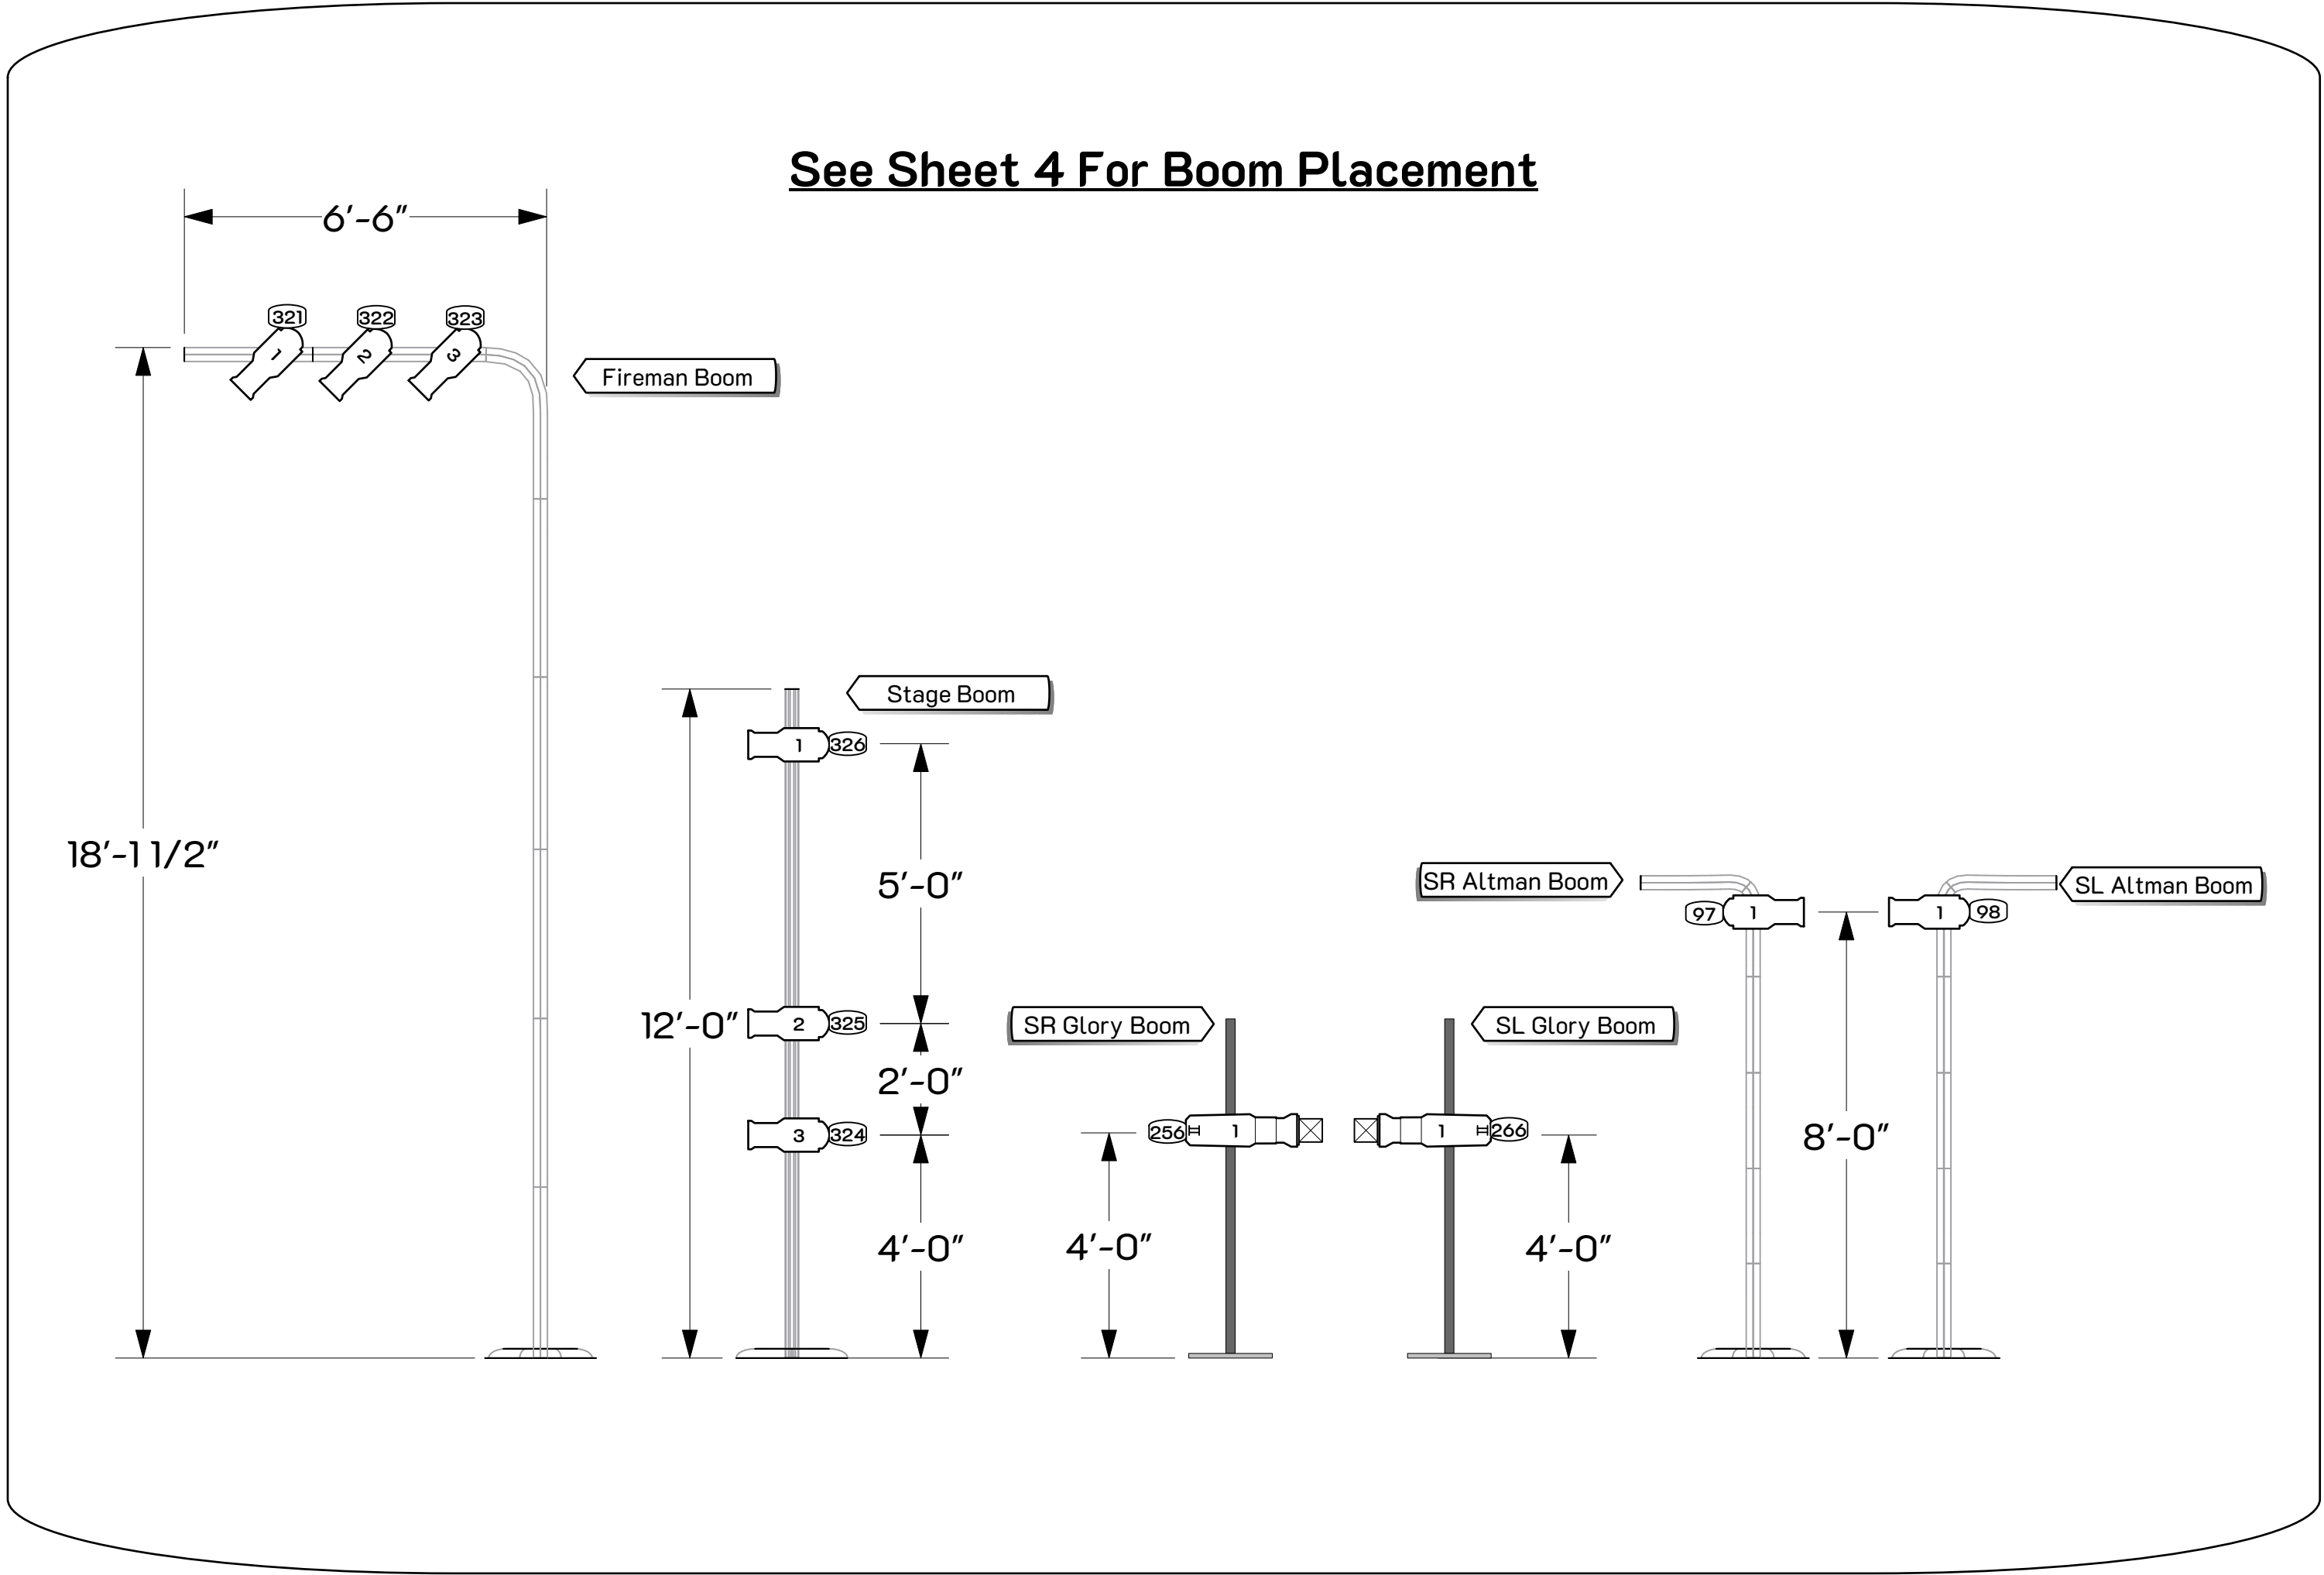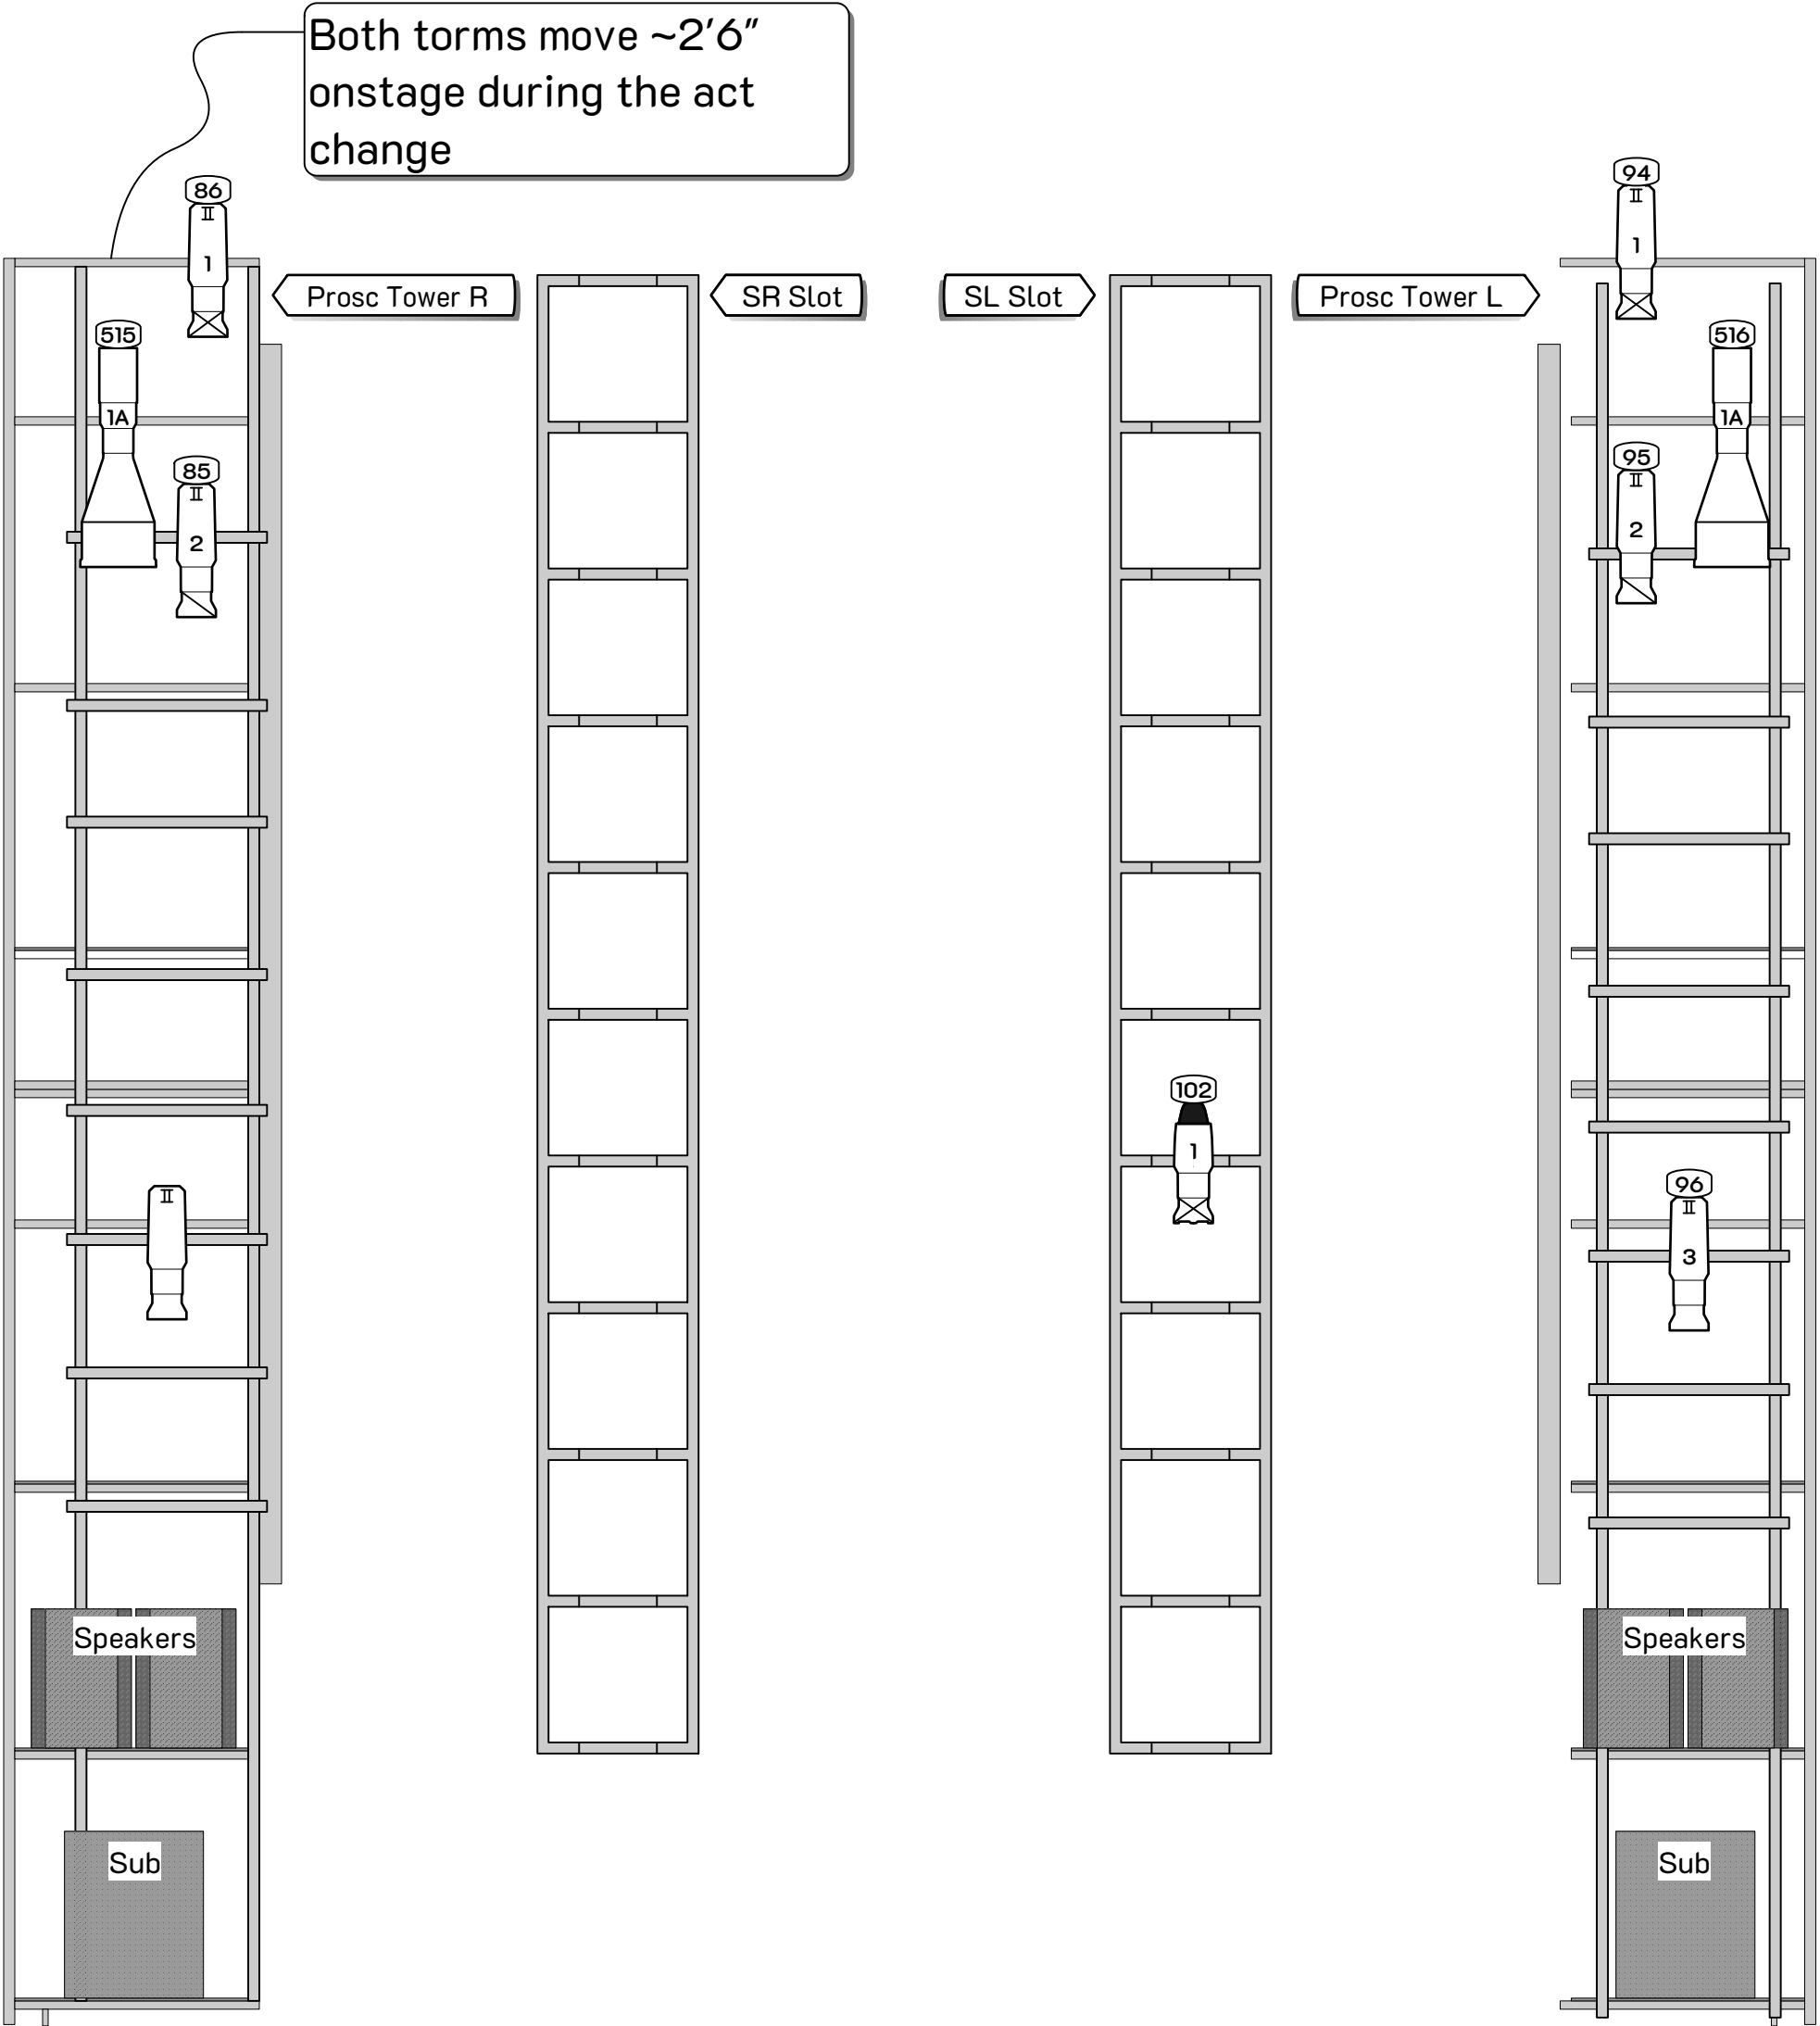

KEY

- Source 4 Bodies
- Source 4 575w
 - Source 4 750w
 - Source 4 Lustr2
 - ColorSource Spot
- Source 4 Barrels
- 5"
 - 10"
 - 14"
 - 10"
 - 20"
 - 36"
 - 50"
 - 70"
 - 90"
- Sola Frame 1000
- SolaFrame 3000
- Varilite VLX Wash
- Robe Robin 150
- PL Cyc
- 8" Fresnel
- Fauxnel
- Practical
- 60w Blue Bulb
- Colorblaze TRX
- 14in Scoop
- Altman 360Q 6x9
- 10" Barndoor
- 6.25in Half Top hat
- M Fader Scroller

NOTES

LEGEND


- UNIT NUMBER
- CHANNEL NUMBER

VERSION	DATE	NOTE

THIS DRAWING REPRESENTS VISUAL CONCEPTS AND CONSTRUCTION SUGGESTIONS ONLY. IT DOES NOT REPLACE THE KNOWLEDGE AND ADVICE OF A LICENSED STRUCTURAL ENGINEER. THE DESIGNER IS UNQUALIFIED TO DETERMINE THE STRUCTURAL APPROPRIATENESS OF THIS DESIGN AND WILL NOT ASSUME RESPONSIBILITY FOR IMPROPER ENGINEERING OR USE.

Director	Lisa Nathans
Lighting Designer	J. Mitchell Cronin
Scenic Designer	Ryan Fox
Costume Designer	Ashlynnne Ludwig
Sound Designer	Bill Brandwein
Asst. Lighting Designer	Matory Hartman
Master Electrician	Carrie Barton

The University of Maryland- TDPS
Noises Off "As-Built" Plot
The Clarice Smith Performing Arts Center
Key Theatre

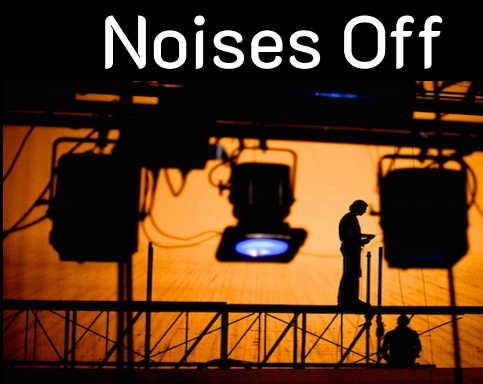

J. MITCHELL CRONIN
LIGHTING DESIGN




DATE	VERSION	SCALE	Sheet Number
5.1.20	3	3/8" = 1'	3 OF 4

Booms

Source 4 Bodies	
Source 4 Barrels	
	Sola Frame 1000
	SolaFrame 3000
	Varilite VLX Wash
	Robe Robin 150
	PL Cyc
	8° Fresnel
	Fauxnel
	Practical
	60w Blue Bulb
	Colorblaze TRX
	14in Scoop
	Altman 360Q 6x9
	10° Barndoor
	6.25in Half Top hat
	M Fader Scroller


LEGEND

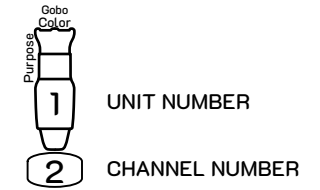[illegible]

THIS DRAWING REPRESENTS VISUAL CONCEPTS AND CONSTRUCTION SUGGESTIONS ONLY. IT DOES NOT REPLACE THE KNOWLEDGE AND ADVICE OF A LICENSED STRUCTURAL ENGINEER. THE DESIGNER IS UNQUALIFIED TO DETERMINE THE STRUCTURAL APPROPRIATENESS OF THIS DESIGN AND WILL NOT ASSUME RESPONSIBILITY FOR IMPROPER ENGINEERING OR USE.

Director	Lisa Nathans
Lighting Designer	J. Mitchell Cronin
Scenic Designer	Ryan Fox
Costume Designer	Ashlynnne Ludwig
Sound Designer	Bill Brandwein
Asst. Lighting Designer	Matory Hartman
Master Electrician	Carrie Barton

The University of Maryland- TDPS
Noises Off "As-Built" Plot
the Clarice Smith Performing Arts Center
Kay Theatre

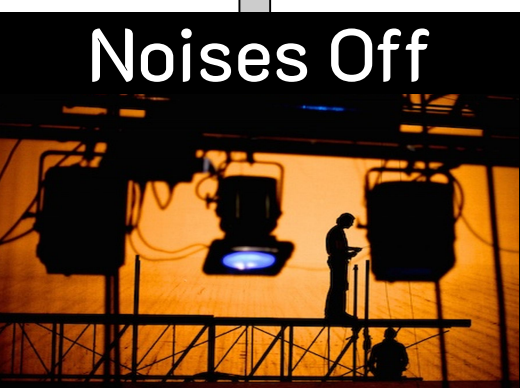

J. MITCHELL CRONIN
LIGHTING DESIGN



DATE 5.1.20	VERSION 3	SCALE 1/2" = 1'-0"	Sheet Number 4 OF 4
Set-Mounted			